


Developments works to be under taken in Ward No.05 of BBMP around Solid Waste Disposal Processing units Bellahalli, D Bagalur and Kattigenahalli Byatarayanapura Constituency

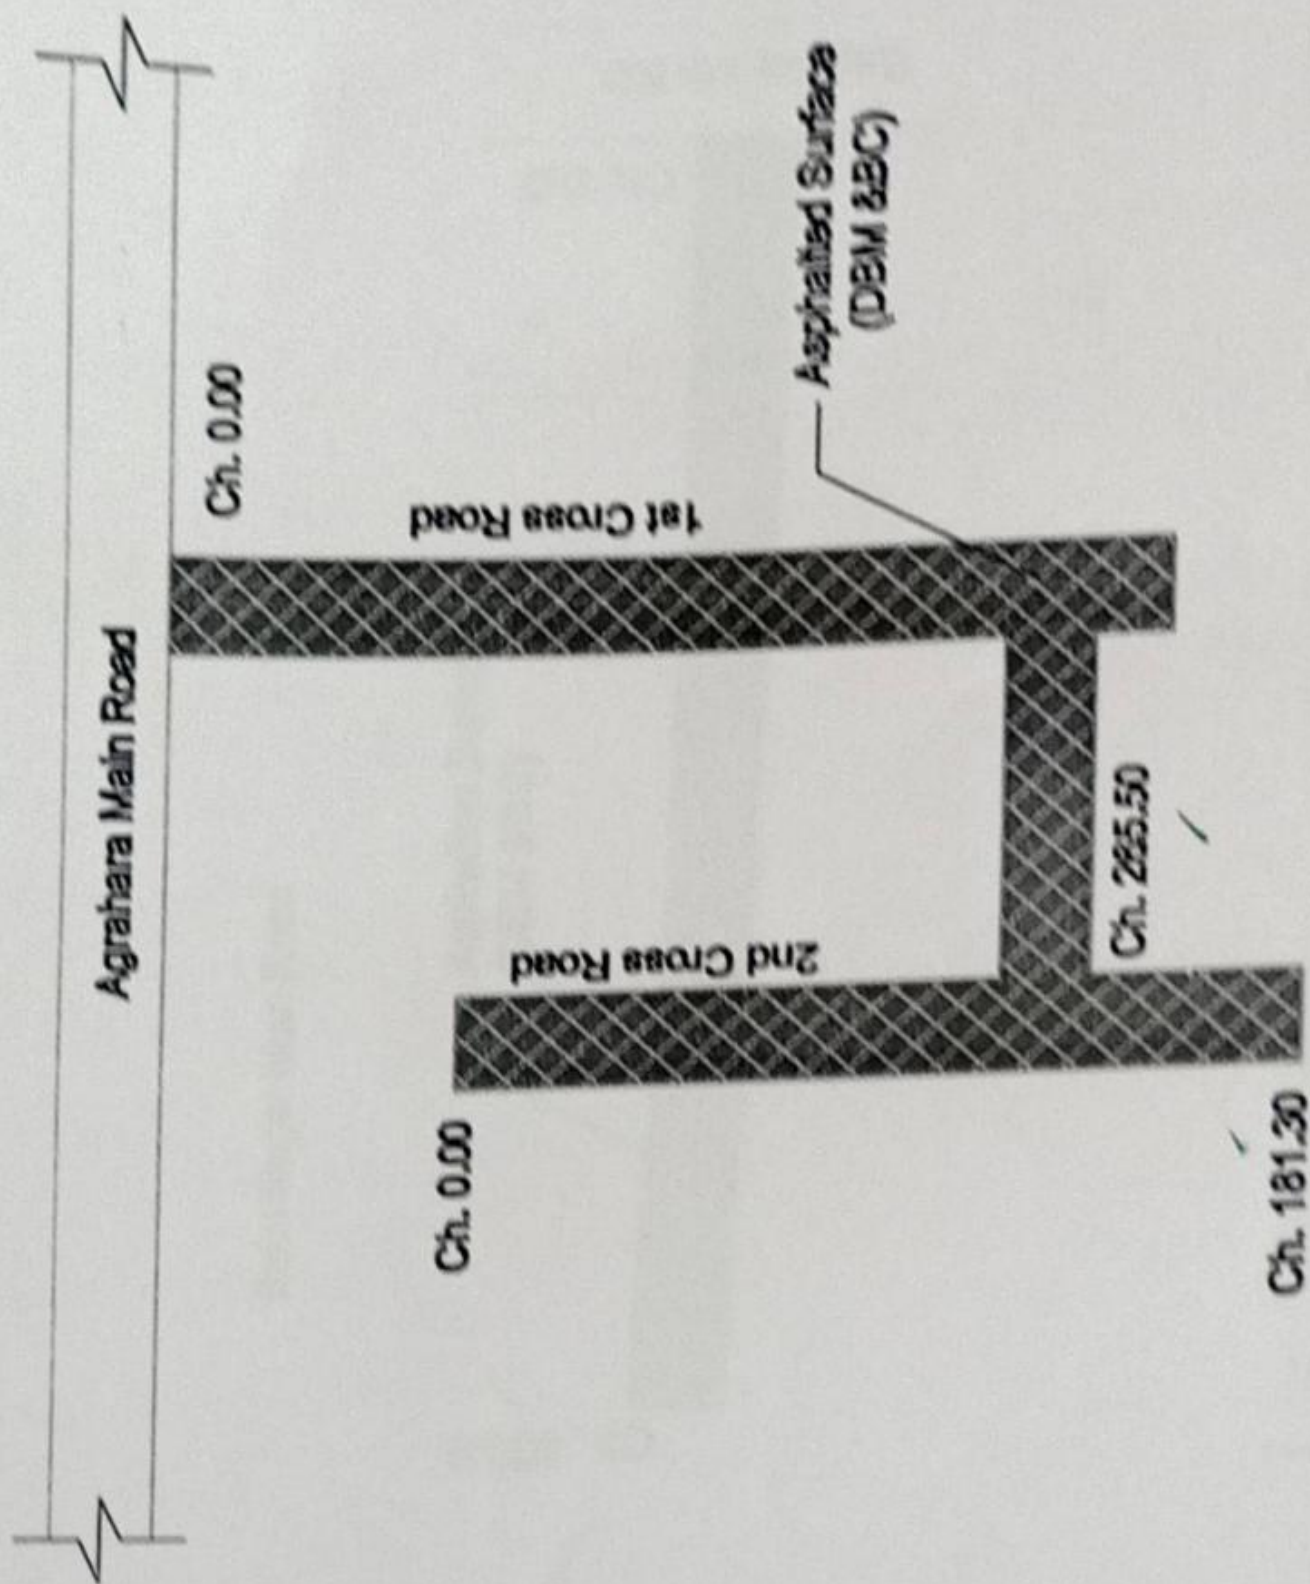

Srinivas Garden Road

Asst. Executive Engineer
Project Division
Yelahanka Zone
Bangalore 92

5512 January, 97

5

ALL INFORMATION CONTAINED HEREIN IS UNCLASSIFIED

Thurlock

[illegible]

	DEM	BC
DEM		

TEAR CONSIDERATIONS

1. **TEAR RESISTANCE**

2. **TEAR PROPAGATION**

3. **TEAR INITIATION**

4. **TEAR STOPPING**

5. **TEAR REPAIR**

6. **TEAR PREVENTION**

7. **TEAR DETECTION**

8. **TEAR TOLERANCE**

9. **TEAR RESISTANCE**

10. **TEAR PROPAGATION**

11. **TEAR INITIATION**

12. **TEAR STOPPING**

13. **TEAR REPAIR**

14. **TEAR PREVENTION**

15. **TEAR DETECTION**

16. **TEAR TOLERANCE**

17. **TEAR RESISTANCE**

18. **TEAR PROPAGATION**

19. **TEAR INITIATION**

20. **TEAR STOPPING**

21. **TEAR REPAIR**

22. **TEAR PREVENTION**

23. **TEAR DETECTION**

24. **TEAR TOLERANCE**

25. **TEAR RESISTANCE**

26. **TEAR PROPAGATION**

27. **TEAR INITIATION**

28. **TEAR STOPPING**

29. **TEAR REPAIR**

30. **TEAR PREVENTION**

31. **TEAR DETECTION**

32. **TEAR TOLERANCE**

33. **TEAR RESISTANCE**

34. **TEAR PROPAGATION**

35. **TEAR INITIATION**

36. **TEAR STOPPING**

37. **TEAR REPAIR**

38. **TEAR PREVENTION**

39. **TEAR DETECTION**

40. **TEAR TOLERANCE**

41. **TEAR RESISTANCE**

42. **TEAR PROPAGATION**

43. **TEAR INITIATION**

44. **TEAR STOPPING**

45. **TEAR REPAIR**

46. **TEAR PREVENTION**

47. **TEAR DETECTION**

48. **TEAR TOLERANCE**

49. **TEAR RESISTANCE**

50. **TEAR PROPAGATION**

51. **TEAR INITIATION**

52. **TEAR STOPPING**

53. **TEAR REPAIR**

54. **TEAR PREVENTION**

55. **TEAR DETECTION**

56. **TEAR TOLERANCE**

57. **TEAR RESISTANCE**

58. **TEAR PROPAGATION**

59. **TEAR INITIATION**

60. **TEAR STOPPING**

61. **TEAR REPAIR**

62. **TEAR PREVENTION**

63. **TEAR DETECTION**

64. **TEAR TOLERANCE**

65. **TEAR RESISTANCE**

66. **TEAR PROPAGATION**

67. **TEAR INITIATION**

68. **TEAR STOPPING**

69. **TEAR REPAIR**

70. **TEAR PREVENTION**

71. **TEAR DETECTION**

72. **TEAR TOLERANCE**

73. **TEAR RESISTANCE**

74. **TEAR PROPAGATION**

75. **TEAR INITIATION**

76. **TEAR STOPPING**

77. **TEAR REPAIR**

78. **TEAR PREVENTION**

79. **TEAR DETECTION**

80. **TEAR TOLERANCE**

81. **TEAR RESISTANCE**

82. **TEAR PROPAGATION**

83. **TEAR INITIATION**

84. **TEAR STOPPING**

85. **TEAR REPAIR**

86. **TEAR PREVENTION**

87. **TEAR DETECTION**

88. **TEAR TOLERANCE**

89. **TEAR RESISTANCE**

90. **TEAR PROPAGATION**

91. **TEAR INITIATION**

92. **TEAR STOPPING**

93. **TEAR REPAIR**

94. **TEAR PREVENTION**

95. **TEAR DETECTION**

96. **TEAR TOLERANCE**

97. **TEAR RESISTANCE**

98. **TEAR PROPAGATION**

99. **TEAR INITIATION**

100. **TEAR STOPPING**

101. **TEAR REPAIR**

102. **TEAR PREVENTION**

103. **TEAR DETECTION**

104. **TEAR TOLERANCE**

105. **TEAR RESISTANCE**

106. **TEAR PROPAGATION**

107. **TEAR INITIATION**

108. **TEAR STOPPING**

109. **TEAR REPAIR**

110. **TEAR PREVENTION**

111. **TEAR DETECTION**

112. **TEAR TOLERANCE**

113. **TEAR RESISTANCE**

114. **TEAR PROPAGATION**

115. **TEAR INITIATION**

116. **TEAR STOPPING**

117. **TEAR REPAIR**

118. **TEAR PREVENTION**

119. **TEAR DETECTION**

120. **TEAR TOLERANCE**

121. **TEAR RESISTANCE**

122. **TEAR PROPAGATION**

123. **TEAR INITIATION**

124. **TEAR STOPPING**

125. **TEAR REPAIR**

126. **TEAR PREVENTION**

127. **TEAR DETECTION**

128. **TEAR TOLERANCE**

129. **TEAR RESISTANCE**

130. **TEAR PROPAGATION**

131. **TEAR INITIATION**

132. **TEAR STOPPING**

133. **TEAR REPAIR**

134. **TEAR PREVENTION**

135. **TEAR DETECTION**

136. **TEAR TOLERANCE**

137. **TEAR RESISTANCE**

138. **TEAR PROPAGATION**

139. **TEAR INITIATION**

140. **TEAR STOPPING**

141. **TEAR REPAIR**

142. **TEAR PREVENTION**

143. **TEAR DETECTION**

144. **TEAR TOLERANCE**

145. **TEAR RESISTANCE**

146. **TEAR PROPAGATION**

147. **TEAR INITIATION**

148. **TEAR STOPPING**

149. **TEAR REPAIR**

150. **TEAR PREVENTION**

183. **TEAR DETECTION**

184. **TEAR TOLERANCE**

185. **TEAR RESISTANCE**

186. **TEAR PROPAGATION**

187. **TEAR INITIATION**

188. **TEAR STOPPING**

189. **TEAR REPAIR**

190. **TEAR PREVENTION**

191. **TEAR DETECTION**

192. **TEAR TOLERANCE**

193. **TEAR RESISTANCE**

194. **TEAR PROPAGATION**

195. **TEAR INITIATION**

196. **TEAR STOPPING**

197. **TEAR REPAIR**

198. **TEAR PREVENTION**

199. **TEAR DETECTION**

200. **TEAR TOLERANCE**

201. **TEAR RESISTANCE**

202. **TEAR PROPAGATION**

203. **TEAR INITIATION**

204. **TEAR STOPPING**

205. **TEAR REPAIR**

206. **TEAR PREVENTION**

207. **TEAR DETECTION**

208. **TEAR TOLERANCE**

209. **TEAR RESISTANCE**

210. **TEAR PROPAGATION**

211. **TEAR INITIATION**

212. **TEAR STOPPING**

213. **TEAR REPAIR**

214. **TEAR PRE**

Developments works to be under taken in Ward No.05 of BBMP around Solid Waste Disposal Processing units Bellahalli,
D Bagalur and Kattigenahalli Byatarayanapura Constituency

Baba Nagar Main Road

**Asphalted Surface
(DBM & BC)**

Ch. 400.0

Ch. 0.0

Bagalur Mn RD

Lundberg ~~te~~

Asst. Executive Engineer
Project Division
Yelahanka Zone

●

ALL INFORMATION CONTAINED HEREIN IS UNCLASSIFIED EXCEPT WHERE SHOWN OTHERWISE

[illegible]

1

DBM

BC



BEAUTY, Bangalore - 56
A TEAM CONSULTANTS

TEJAS CONSULTANTS

As Built Drawing

1

Developments works to be under taken in Ward No.05 of BBMP around Solid Waste Disposal Processing units Bellahalli, D Bagalur and Kattigenahalli Byatarayanapura Constituency

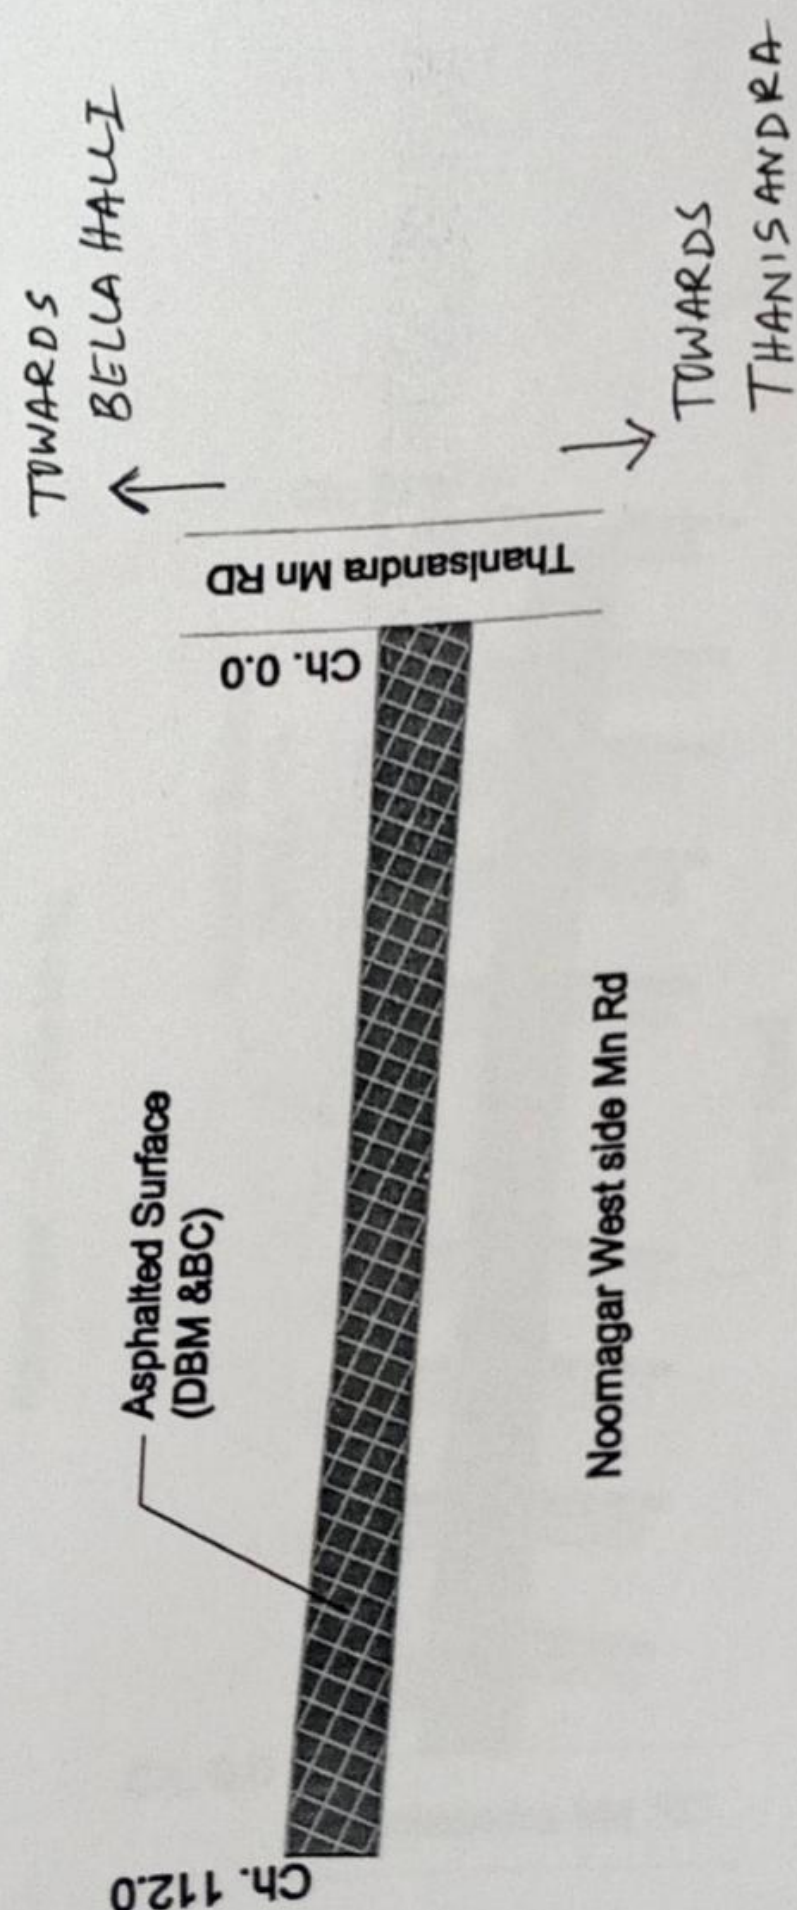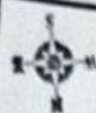

Noomagar West side Mn Rd

~~Kendrick~~



Executive Engineer

Project Division

Washburnka Zone

~~92 Bangalore - 92~~

DBM

BC

[illegible]

LASTING

ALL INFORMATION CONTAINED HEREIN IS UNCLASSIFIED

Discussion:

TEJUS CONSULTANTS

卷一百一十五

1993

As Built Drawing


1



BRUHAT BANGALORE MAHANAGARA PALIKE

Developments works to be under taken in Ward No.05 of BBMP around Solid Waste Disposal Processing units Bellahalli,
D Bagalur and Kattigenahalli Byatarayanapura Constituency


Noomagar East side Mn Rd

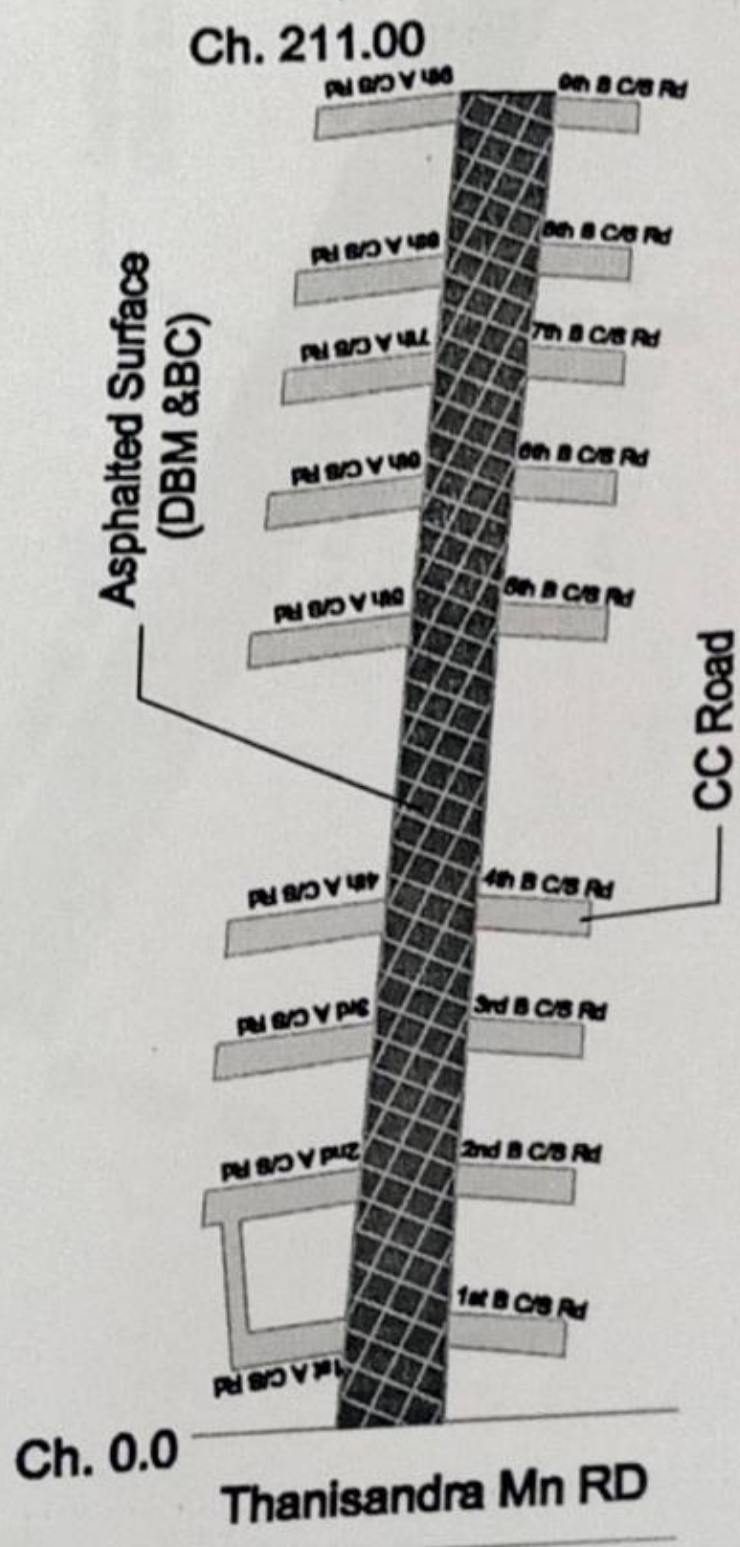

Asst. Executive Engineer
Project Division
Yelahanka Zone
BBMP, Bangalore - 92

TEJUS CONSULTANTS
P. No. 10, 11, 12, 432, 43

Developments works to be under taken in Ward No.05 of BBMP around Solid Waste Disposal Processing units Bellatalli, D Bagalur and Katigenahalli Byalayanapura Constituency

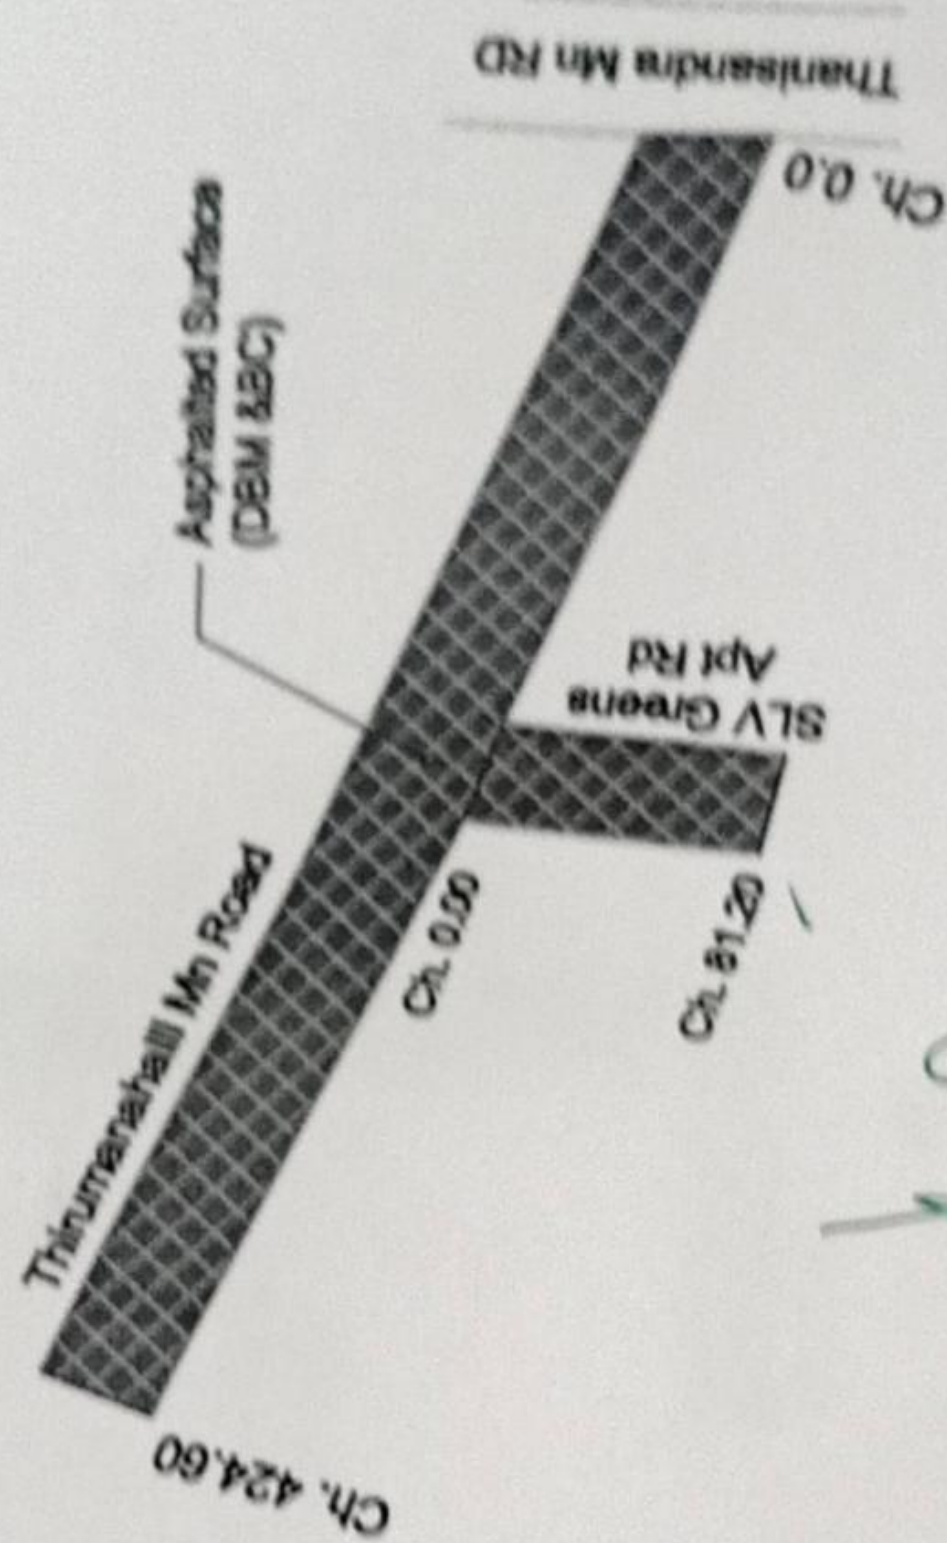

Asst. Executive Engineer

61072

NAME - 26 - 02

5

[illegible]


000753 Zone
NAME - 92
BC

TELL US YOURS TODAY

Am. Bull. Ornithology

BRUHAT BANGALORE MAHANAGARA PALIKE

Developments works to be under taken in Ward No.05 of BBMP around Solid Waste Disposal Processing units Bellahalli,
D Bagalur and Kattigenahalli Byatarayanapura Constituency

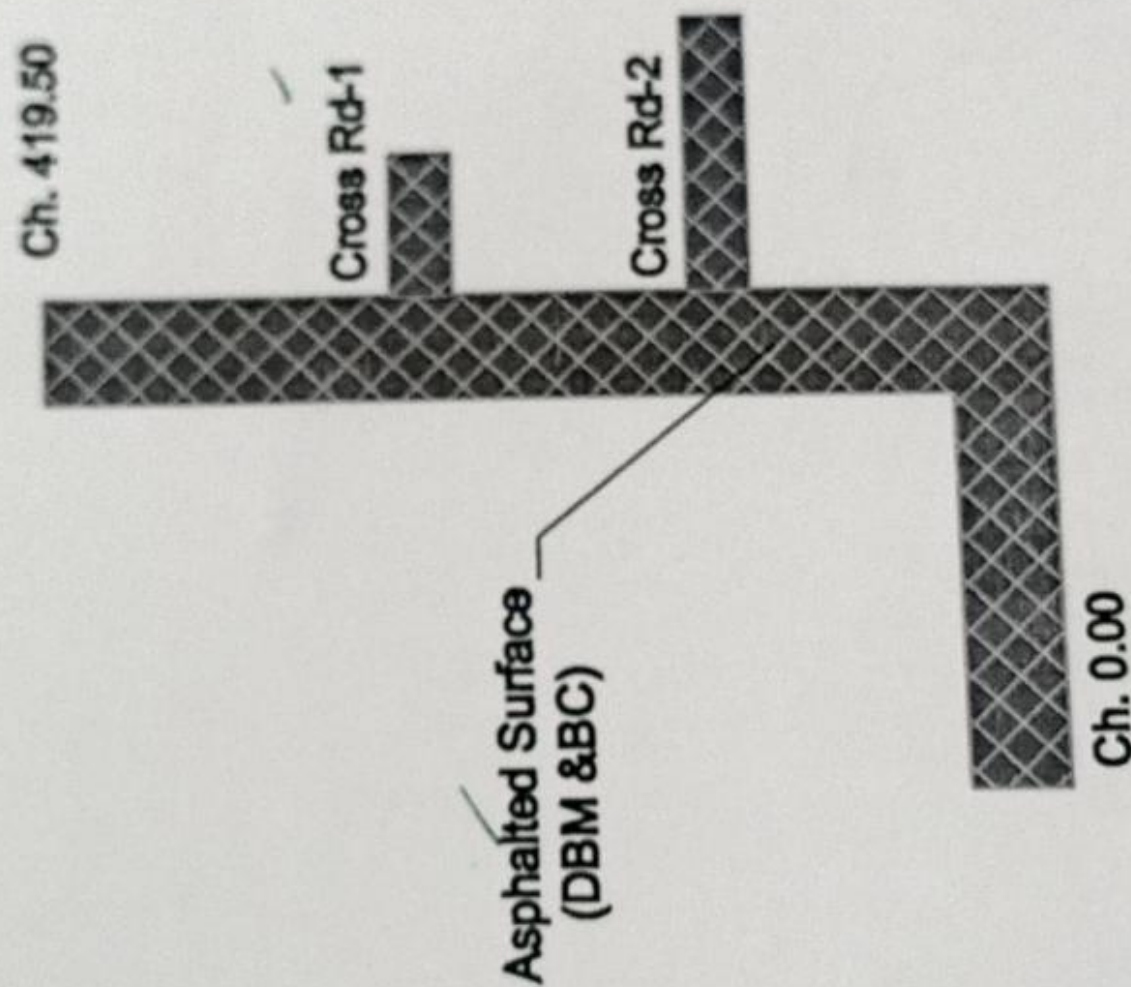

Asst. Executive Engineer
Project Division
Yelahanka Zone
Bengaluru - 92

Lakshamaiah Garden Road

CONSULTANTS:

TIME	As Built Drawing	IS

As Built Drawing

Legend:

DBM

BC

[illegible]

2150

NOTE: ALL DIMENSION & LEVELS ARE AS SHOWN OTHERWISE INDICATED.